



Express Mail No.: EL988725032US
Title: METHOD OF COVERING A POTTED PLANT
Inventors: Donald E. Weder
Filed: Herewith
Agent: Christopher W. Corbett
SHEET 3 OF 22

Deposited: 08/20/2003
Group: 3644
Examiner: F. Palo
Dkt. No.: 8403.954
Redline Drawings HUKNINI KYVY SI 50

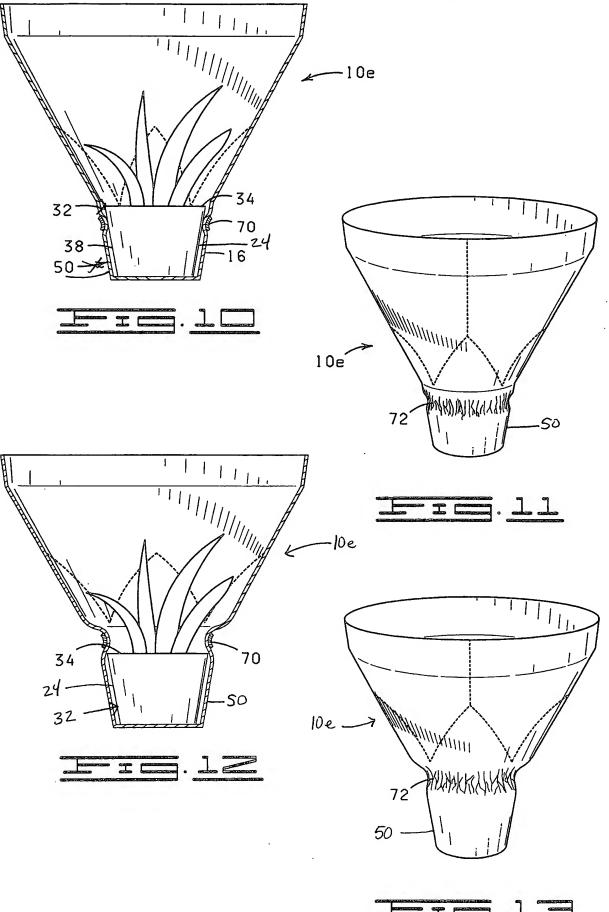

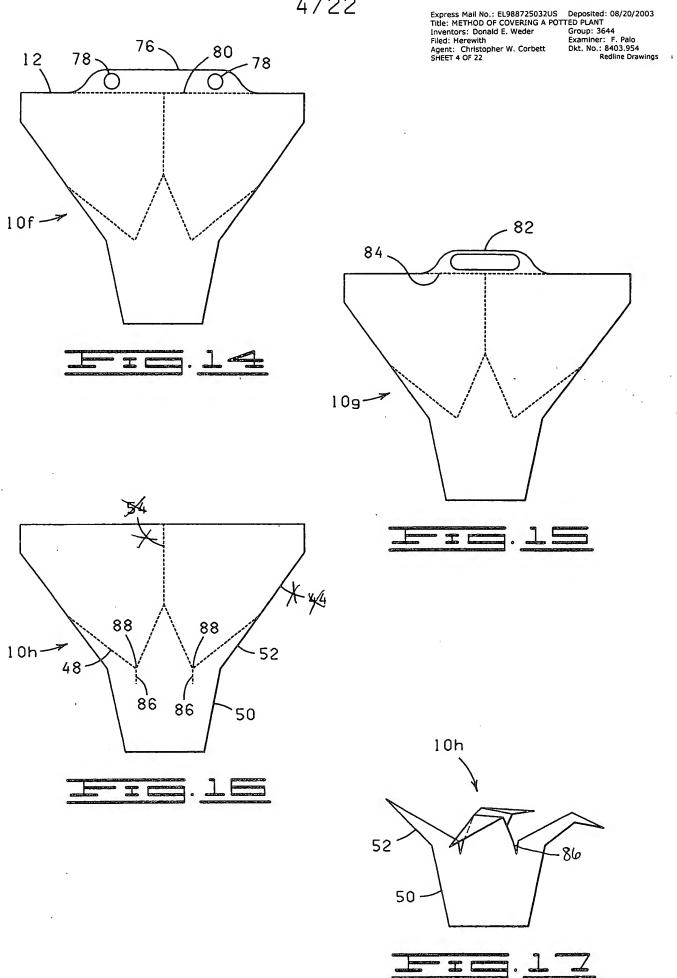

Express Mail No.: EL988725032US

Title: METHOD OF COVERING A POTTED PLANT
Inventors: Donald E. Weder
Filed: Herewith
Agent: Christopher W. Corbett
SHEET 5 OF 22

Deposited: 08/20/2003

Poposited: 08/20/2003

Teposited: 08/20/2003

Poposited: 08/20/2003


Poposited: 08/20/2003


Poposited: 08/20/2003


Poposited: 08/20/2003


Deposited: 08/20/2003


Poposited: 08/20/2003

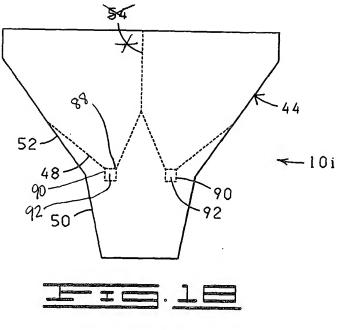


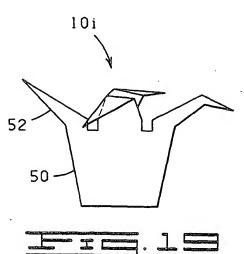


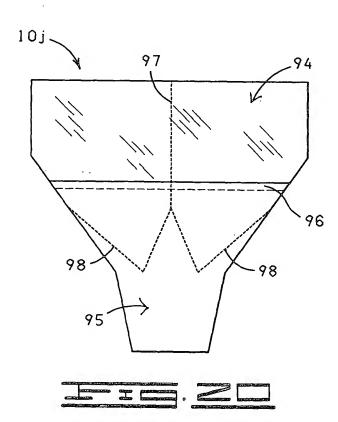


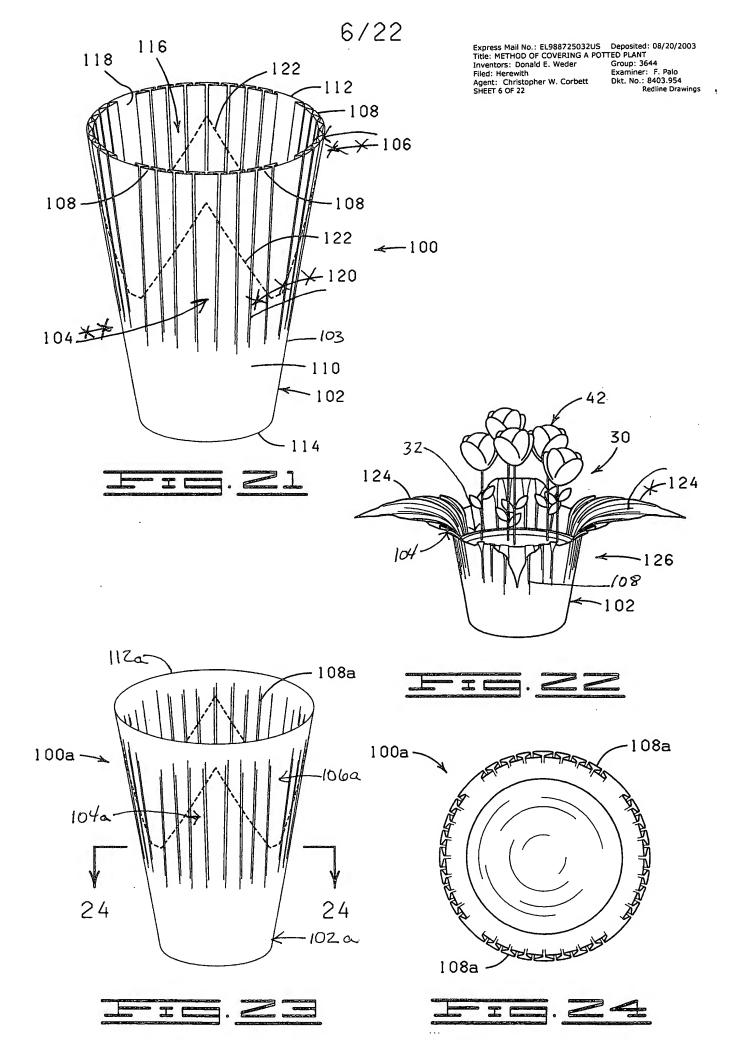

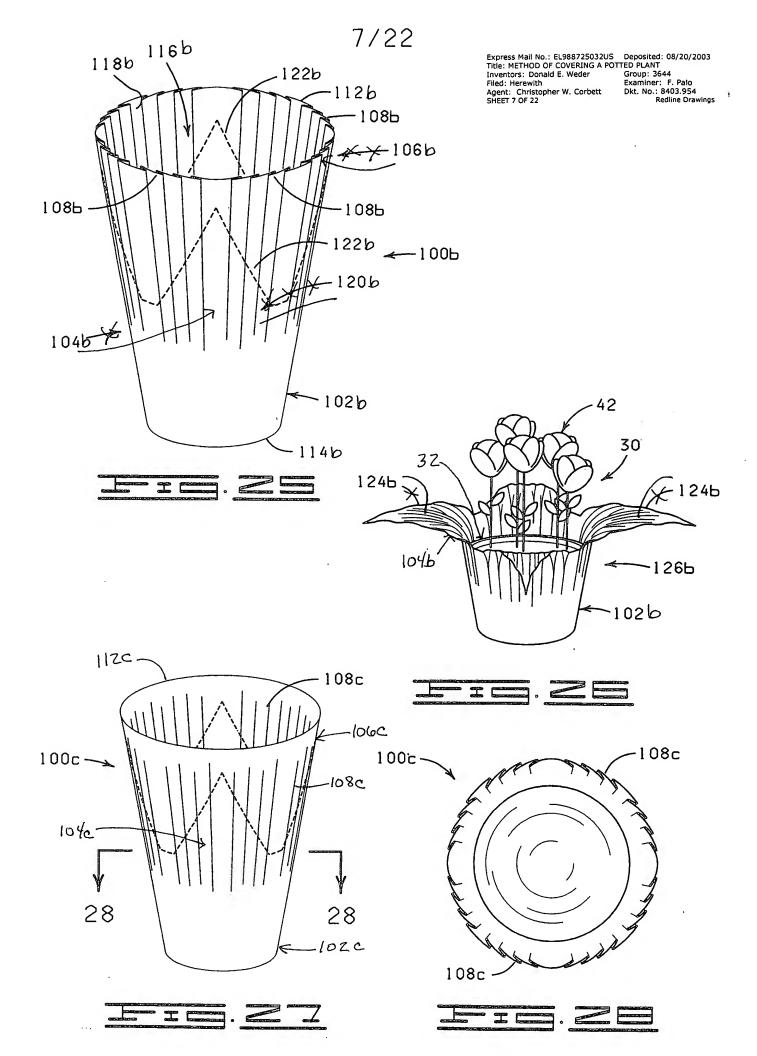


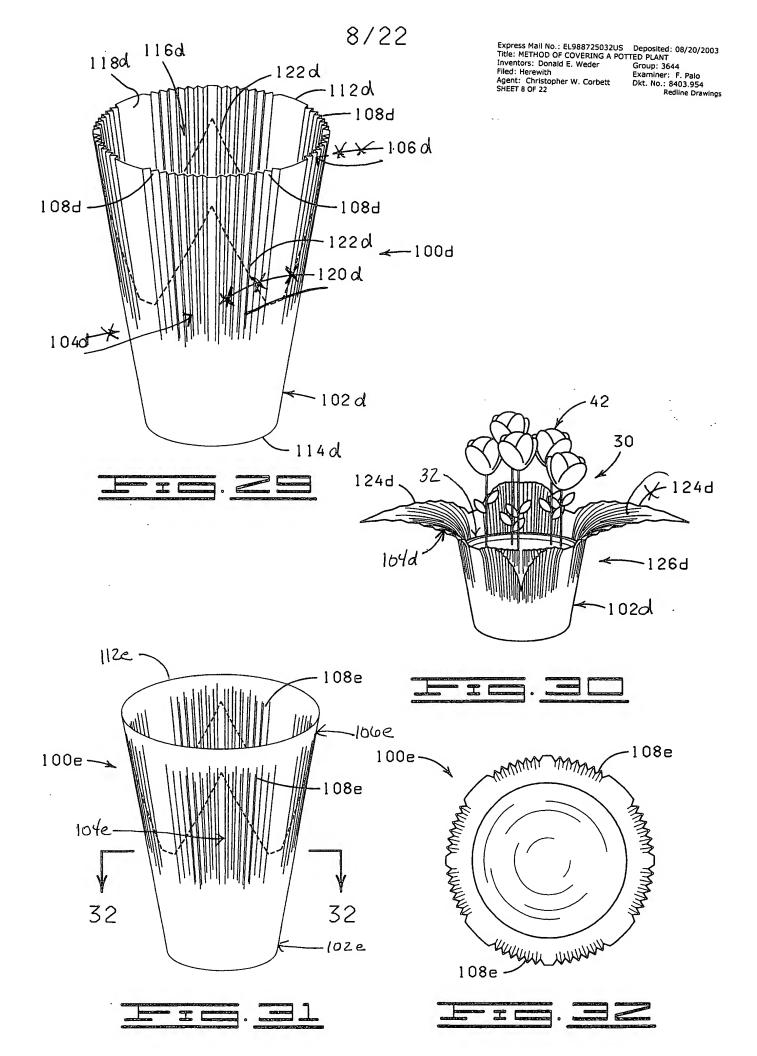


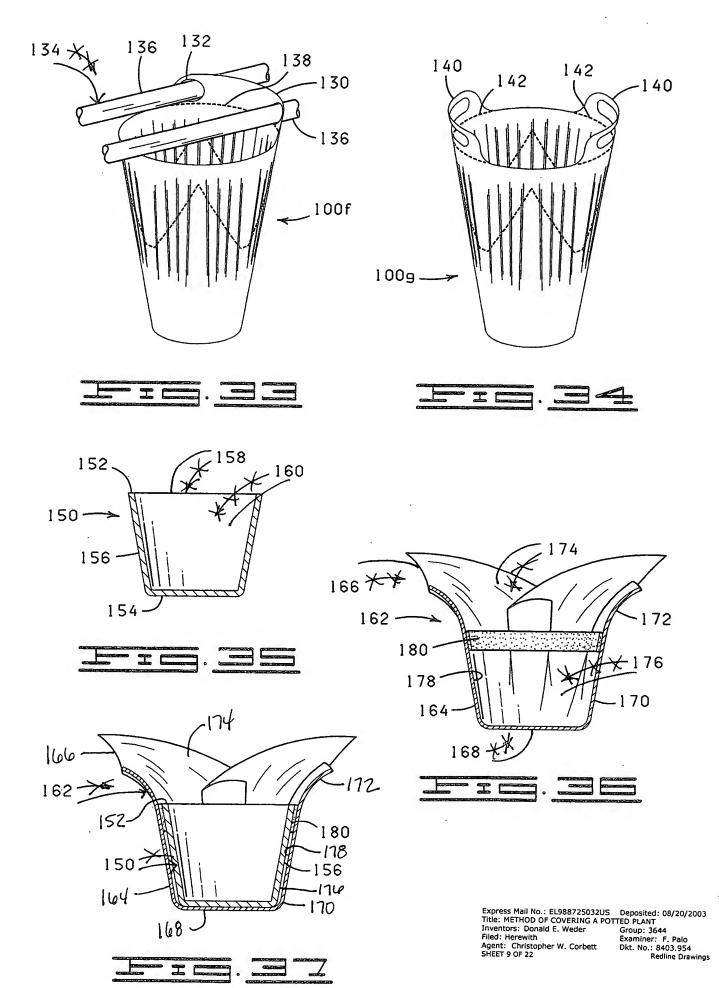

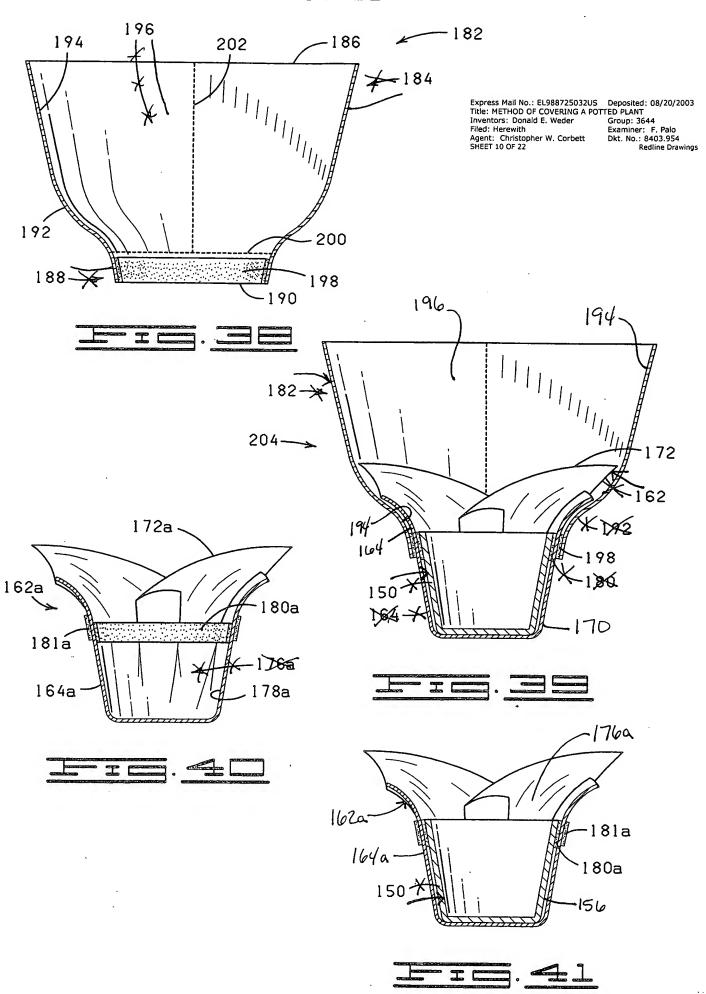

Express Mail No.: EL988725032US Deposited: 08/20/2003
Title: METHOD OF COVERING A POTTED PLANT
Inventors: Donald E. Weder Filed: Herewith Examiner: F. Palo
Agent: Christopher W. Corbett Dkt. No.: 8403.954
SHEET 12 OF 22 Redline Drawings

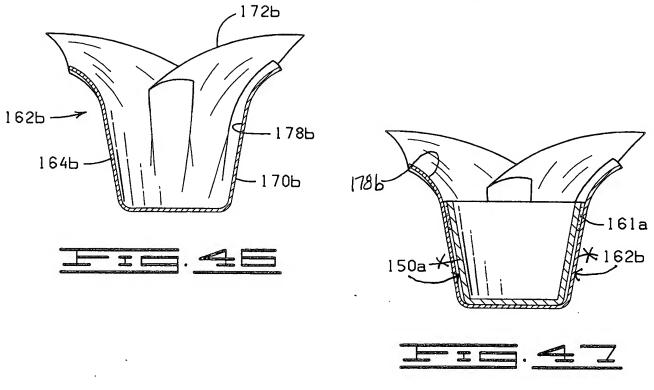

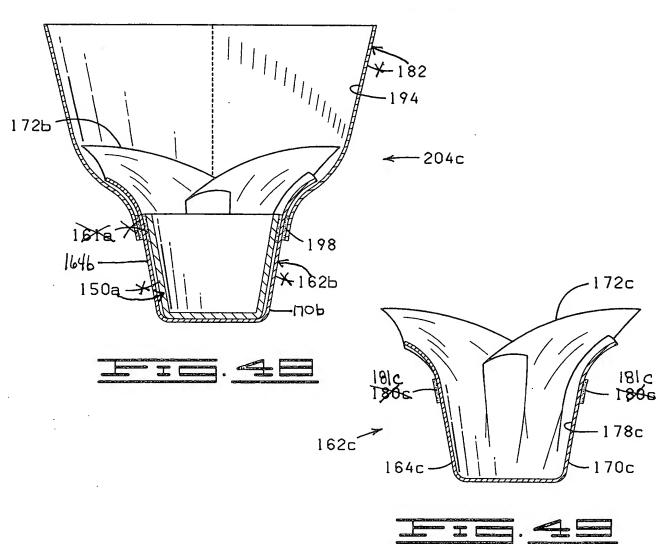


Express Mail No.: EL988725032US
Title: METHOD OF COVERING A POTTED PLANT
Inventors: Donald E. Weder
Filed: Herewith
Agent: Christopher W. Corbett
SHEET 14 OF 22

Deposited: 08/20/2003
Group: 3644
Examiner: F. Palo
Dkt. No.: 8403.954
Redline Drawings


\_ 218 226. 228 220 216 -212 226 218 -228 \_ 220 232 -- 230 230 230-222 -210 212 210-222 1111 214


Express Mail No.: EL988725032US
Title: METHOD OF COVERING A POTTED PLANT
Inventors: Donald E. Weder
Filed: Herewith Examiner: F, Palo
Agent: Christopher W. Corbett
SHEET 15 OF 22
Deposited: 08/20/2003
Group: 3644
Examiner: F, Palo
Dkt. No.: 8403.954
Redline Drawings


252 244 242 242a 256a 240a 240a 241a

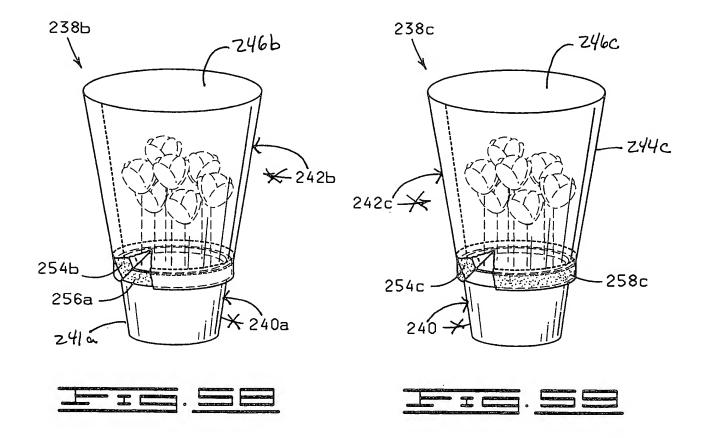


Express Mail No.: EL988725032US Deposited: 08/20/2003
Title: METHOD OF COVERING A POTTED PLANT
Inventors: Donald E. Weder
Filed: Herewith Group: 3644
Examiner: F. Palo
Dkt. No.: 8403.954
Redline Drawings

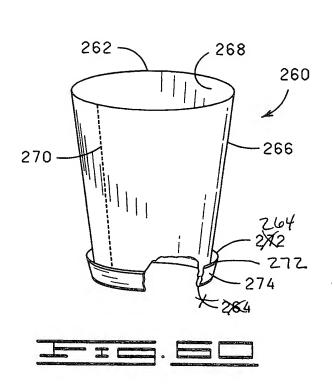


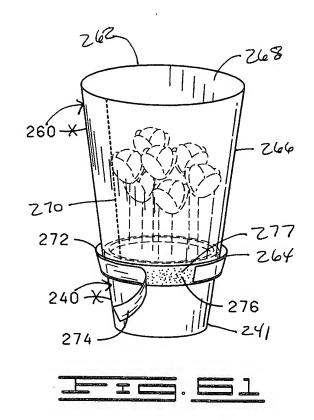


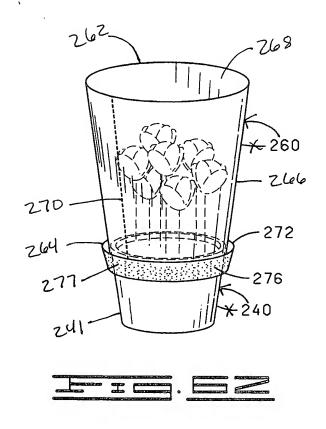

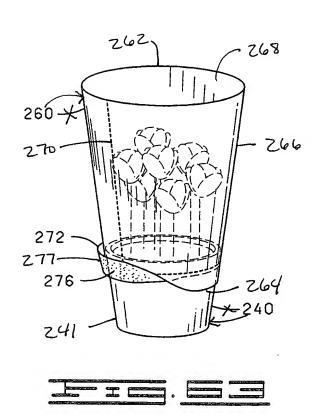


Express Mail No.: EL988725032US Deposited: 08/20/2003
Title: METHOD OF COVERING A POTTED PLANT
Inventors: Donald E. Weder
Filed: Herewith Group: 3644
Examiner: F. Palo
Dkt. No.: 8403.954
Redline Drawings

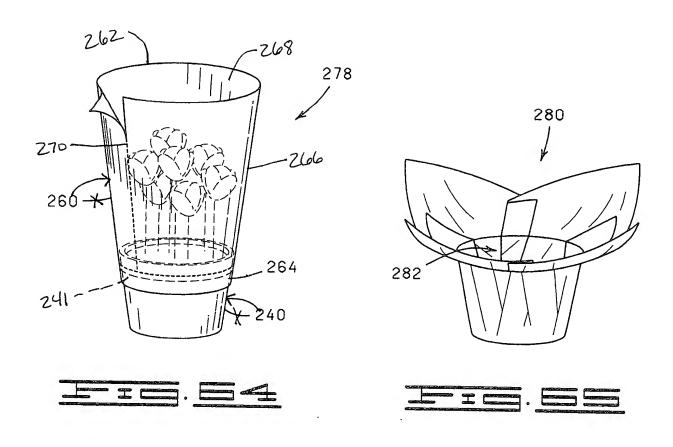


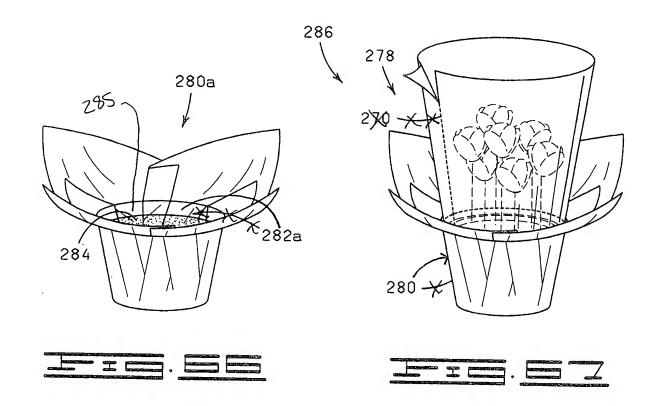

Express Mail No.: EL988725032US
Title: METHOD OF COVERING A POTTED PLANT
Inventors: Donald E. Weder
Filed: Herewith
Agent: Christopher W. Corbett
SHEET 18 0F 22

Deposited: 08/20/2003
Group: 3644
Examiner: F. Palo
Dkt. No.: 8403.954
Redline Drawings - 288 297 292 - 298 290 310 - 302 294 308-296 -300 314 306 312-- 288 316-304 290 <del>×</del>310 314 - 300 288 294-292 304 306 304 318 318 308 300 ×

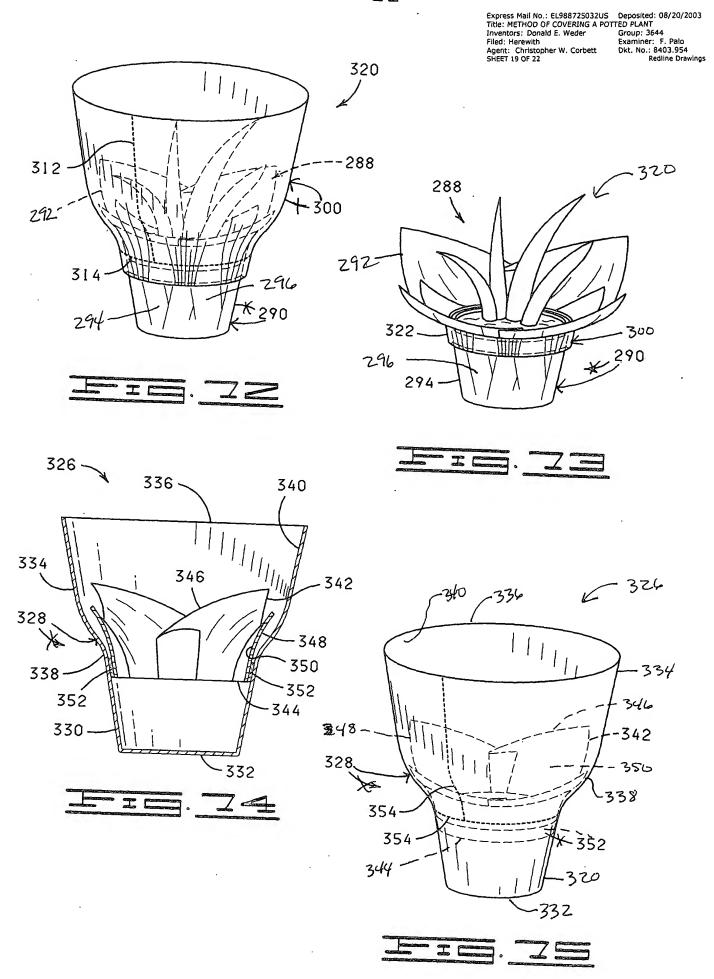

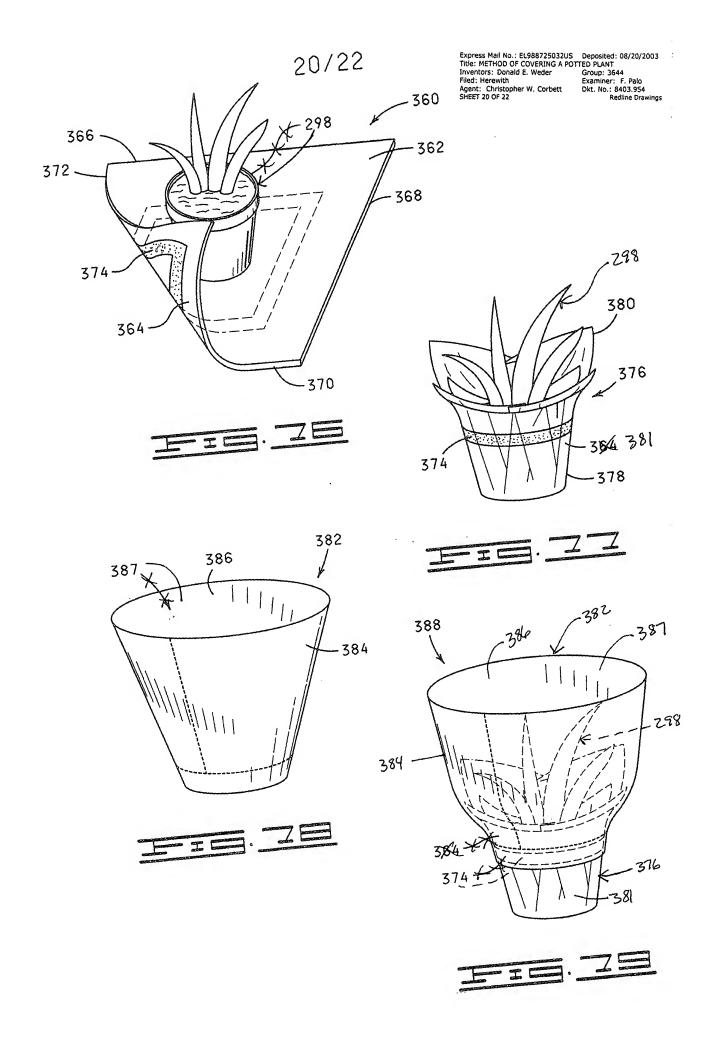


406

412

288 414

290

296

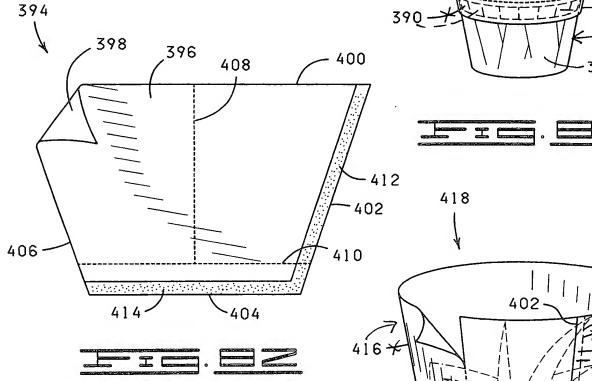

408

410

382a

390

I

386a

